


This represents the basic style and format for As-Built Record Drawings to be received by the Indian River County Department of Utility Services. Refer to drawings M-16, M16(A) and M-16(B) for the minimum information requirements to be provided by the engineer of record to IRCDUS on reproducible (mylar); original As-Built survey to be signed, sealed and dated. An electronic copy of the survey drawings shall also be provided on a CD in Autocad 2007 format or latest version.

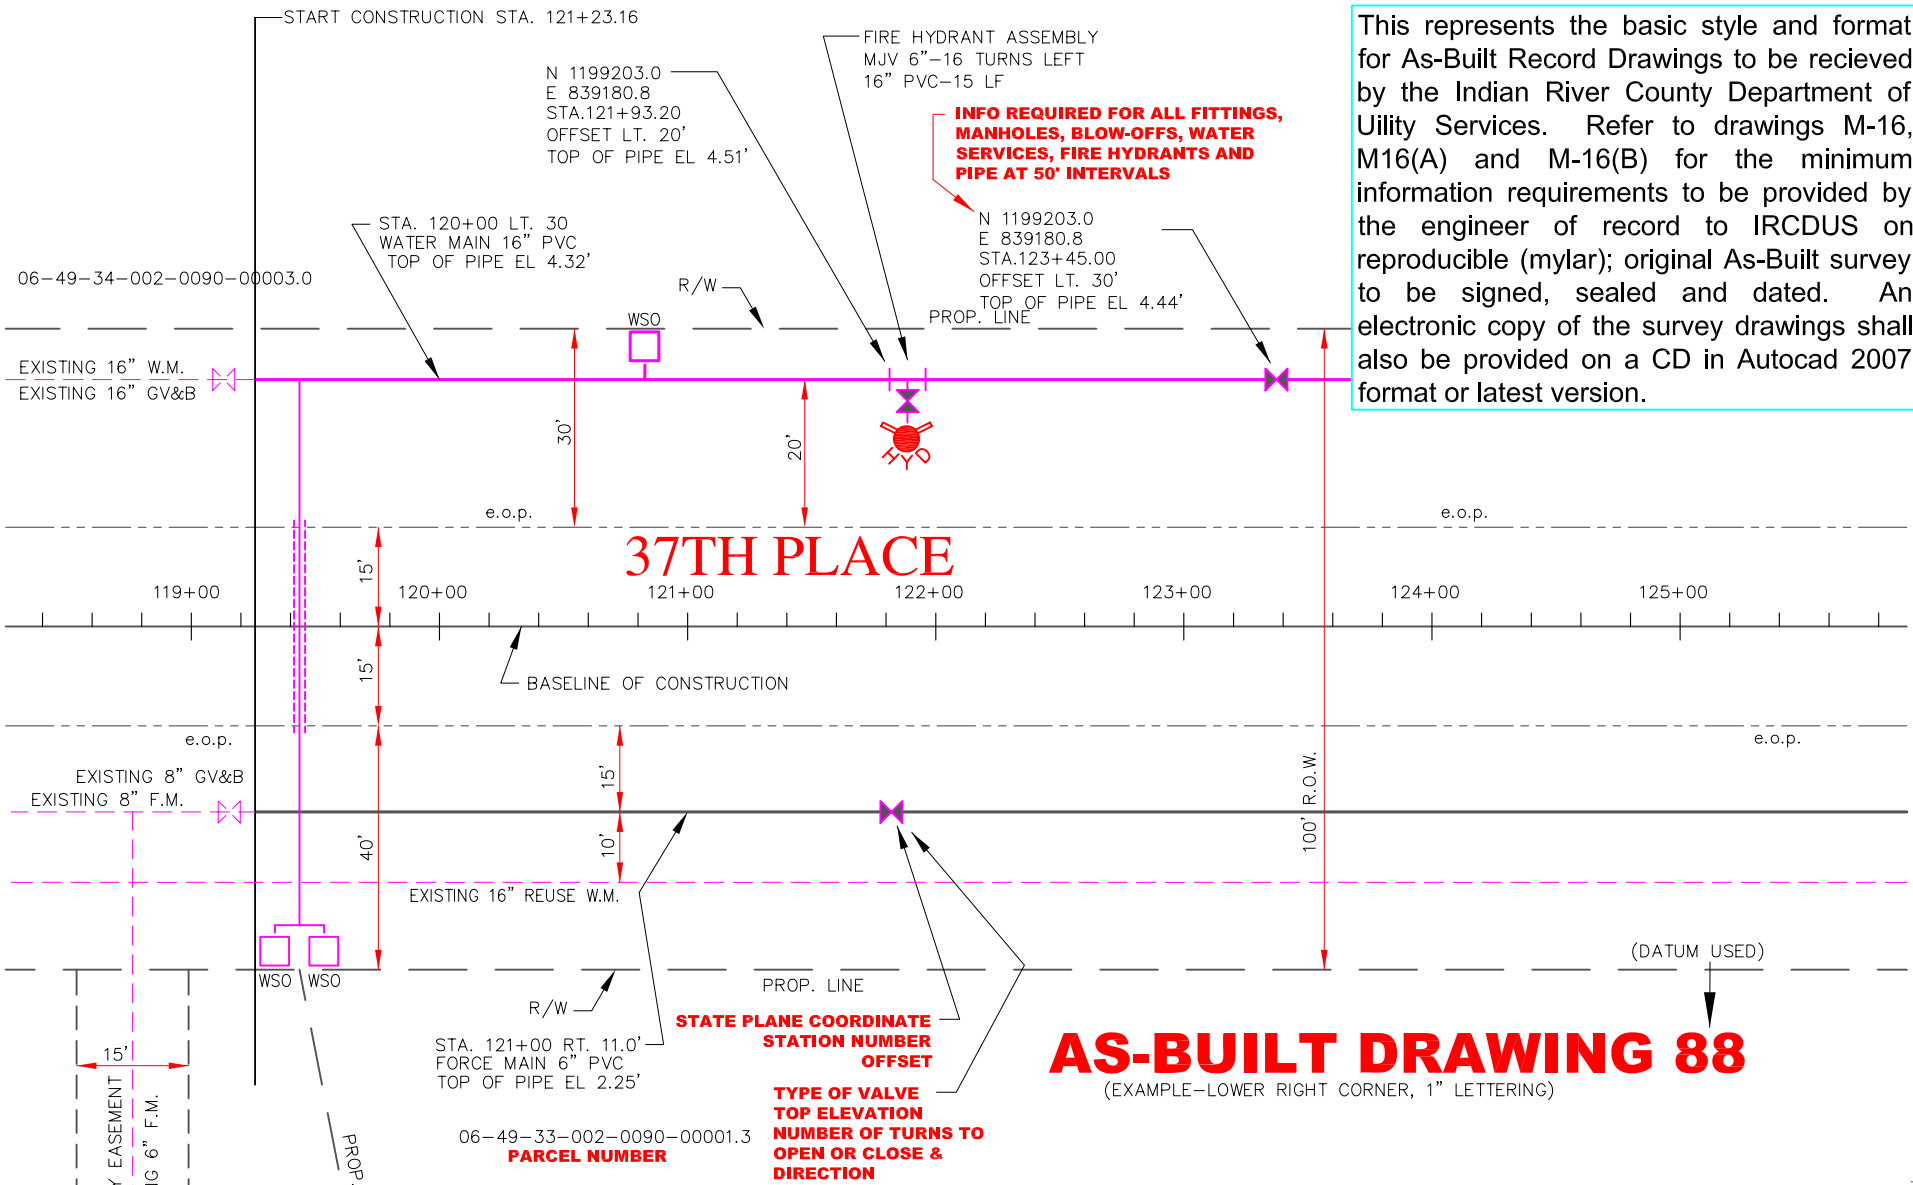

**AS-BUILT DRAWING 88**  
(EXAMPLE—LOWER RIGHT CORNER, 1" LETTERING)

INDIAN RIVER COUNTY DEPARTMENT OF UTILITIES SERVICES		AS-BUILT DRAWING (EXAMPLE)	DRAWING NO. M-14  MARCH 2014
--	--	-------------------------------	--